

SUBSEA MATTRESS PRE-RELEASE & AS-LAID 4-PANEL VERIFICATION CHART | CROSSING: CR-A1_L1 **LOCATION ID: CR-A1_M15 | MATTRESS TAG ID: #A046 | ADVISORY (CHECK OFFSET)**


PANEL 1: CROSSING ARRAY (CR-A1_L1) | Scale 1:250 @ A3

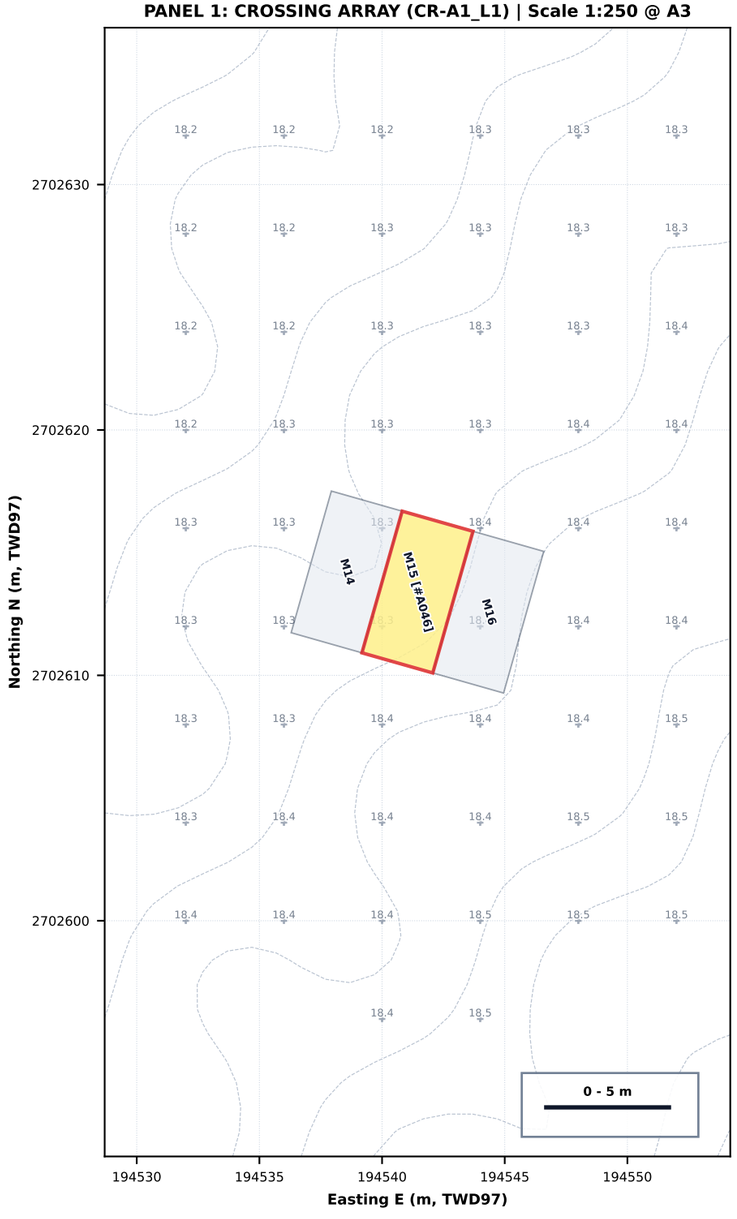


PANEL 2: LOCAL PLAN VIEW (CR-A1_M15 / #A046) | Scale 1:75 @ A3

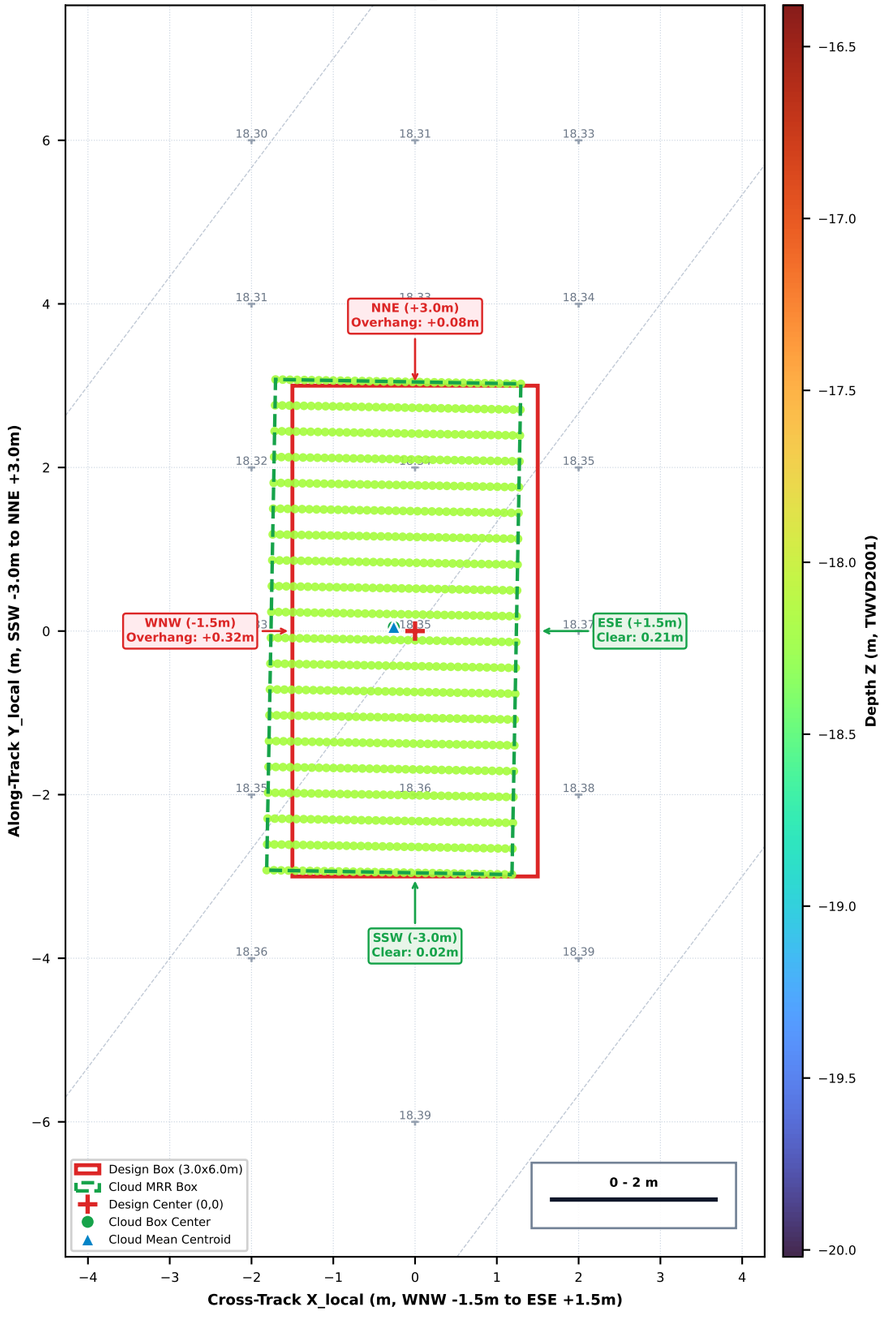

PANEL 3: LONGITUDINAL PROFILE (SSW -> NNE)
H-Scale 1:75 | V-Scale 1:15 @ A3

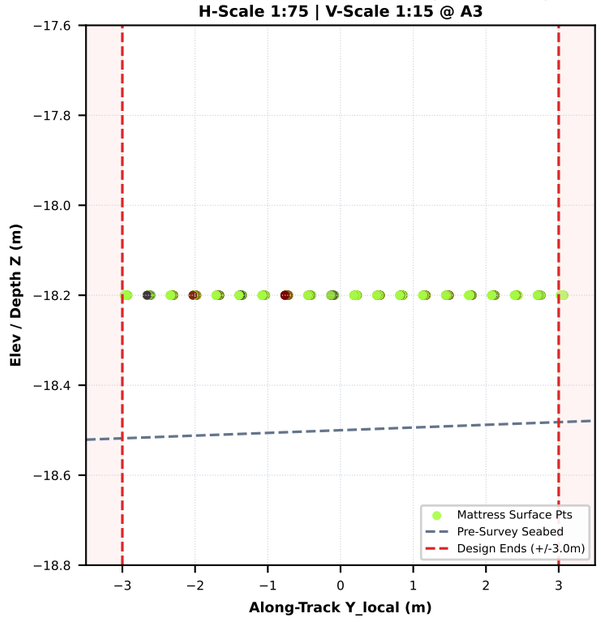

PANEL 4: LATERAL PROFILE (WNW -> ESE)
H-Scale 1:50 | V-Scale 1:15 @ A3

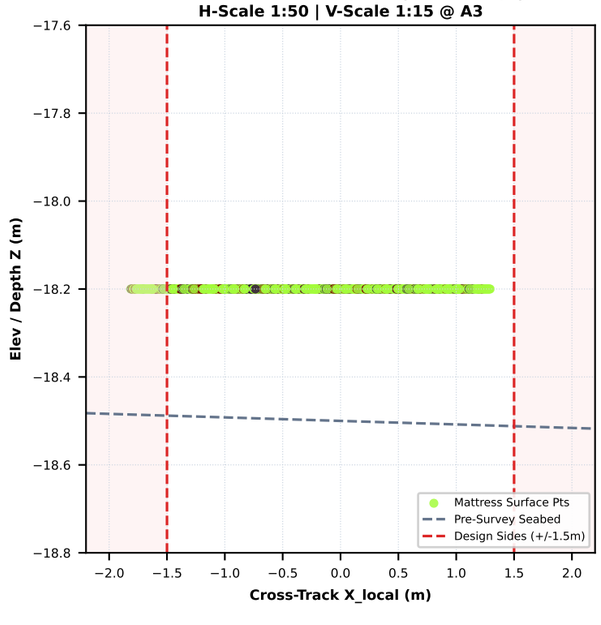

PROJECT: Tung-Hsiao 2nd Stage Subsea Gas Pipeline
CLIENT: Taiwan Power Company (TPC) | CONTRACTOR: NMDC
VESSEL: DP2 MMA Prestige | DATUM: TWD97 (EPSG:3826) / TWVD2001

DESIGN CENTER (CR-A1_M15): E 194541.443 m, N 2702613.394 m
AS-LAID BOX CENTER (#A046): E 194541.206 m, N 2702613.513 m (Z: -18.20 m)
RADIAL OFFSET: 0.265 m (dAlong: +0.05m, dCross: -0.26m)

BRG (S): Des 195.85 deg | Act 196.89 deg (dAz +1.03 deg)
MRR BOX: 6.00x3.00 m | IN BOX: 85.6% (700 pts)
CRANE NUDGE TO DESIGN: 0.27 m toward ESE (116.7 deg)

FILE: 20261104_Mattress_CR-A1_M15_A046.pdf
SCALES @ A3: P1 1:250 | P2 1:75 | P3 1:75/1:15 | P4 1:50/1:15
DATE: 2026-11-04 14:34 | ADVISORY (CHECK OFFSET